


# AS BUILT

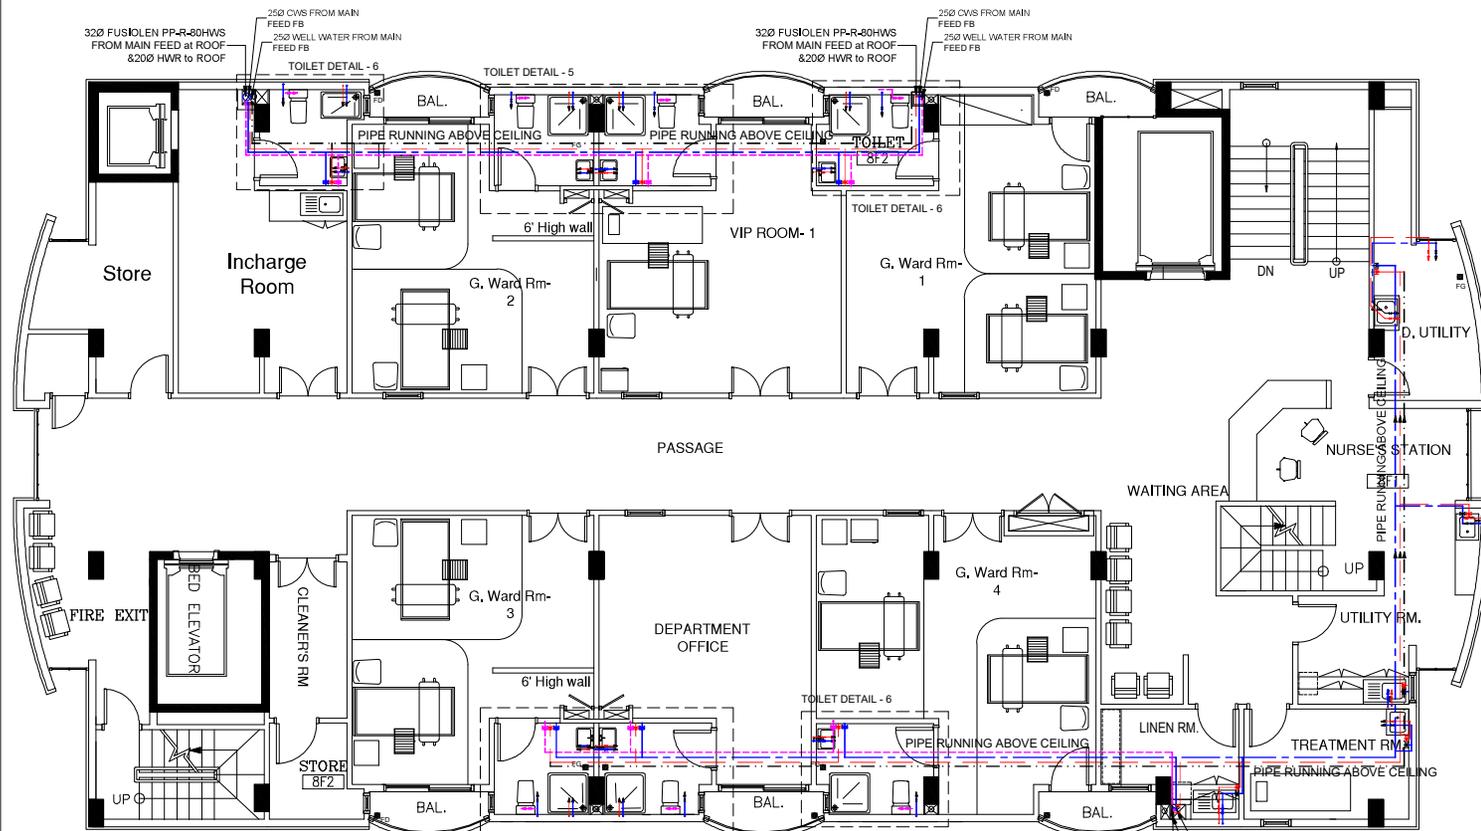

### ABBREVIATION:

- C.W.S Cold Water for Sink/wb/Tub/wc
- H.W.S Hot Water Supply(Insulated)
- H.W.R Hot Water Return(Insulated)
- V.P Vent Pipe
- R.M Rising Main
- D.O.C Drain Of Cock
- O.F Over Flow
- G.V Gate Valve
- I.V Isolating Valve/Angle Valve
- N.R.V Non Return Valve
- R.T.A Riser to Above
- R.F.B Riser From Below
- D.T.B Drop To Below
- D.F.A Drop From Above
- T.A To Above
- T.B To Below
- F.A From Above
- F.B From Below
- P.S Perennial Spray
- W.B Wash Basin
- S.H Shower

### NOTE:

- Cold water for sink/wb/shower
- Hot water supply(Insulated)
- Hot water Return(Insulated)
- Well water for Water Closet
- ⊠ STOP VALVE COLD WATER
- ⊠ STOP VALVE HOT WATER
- ⊠ STOP VALVE WELL WATER

**8TH FLOOR LAYOUT PLAN**  
SCALE 1:100

PROPOSED BUILT UP AREA = 417.4 m2

Vertical Fresh Water	Pump to 3rd fl. Ø40mm, pipe
Vertical Fresh Water	4th to 6th fl. Ø32mm, pipe
Vertical Fresh Water	7th to Terrace fl. Ø25mm, pipe
Vertical Ground Water	Pump to 3rd fl. Ø40mm, pipe
Vertical Ground Water	4th to 6th fl. Ø32mm, pipe
Vertical Ground Water	7th to Terrace fl. Ø25mm, pipe
Horizontal Fresh Water Main line	All the floor Ø25mm pipe
Horizontal Ground Water Main line	All the floor Ø25mm pipe



MAIN CONTRACTOR:	CONSULTANT:	CLIENT:	PROJECT	TITLE												
<p>52, Boduthakurufaanu Magu, Maafannu, Male' 20-01, Maldives, Tel +960 3324369 Fax: +960 3329142 Email: amin@dhivehinet.net.mv Web: http://www.amin.com.mv</p>		MINISTRY OF HEALTH	<b>PROPOSED ADDITIONAL WARDS FOR INDIRA GANDHI MEMORIAL HOSPITAL</b>	<b>8TH FLOOR WATER SUPPLY LAYOUT PLAN</b>												
				<table border="1"> <tr> <td>DRAWN BY:</td> <td>ZAHID</td> <td>CHECKED BY:</td> <td></td> </tr> <tr> <td>DRG. NO.:</td> <td>PL - 09</td> <td>DATE:</td> <td>02-09-2015</td> </tr> <tr> <td>SCALE:</td> <td><b>1:100</b></td> <td>PAGE:</td> <td>09</td> </tr> </table>	DRAWN BY:	ZAHID	CHECKED BY:		DRG. NO.:	PL - 09	DATE:	02-09-2015	SCALE:	<b>1:100</b>	PAGE:	09
DRAWN BY:	ZAHID	CHECKED BY:														
DRG. NO.:	PL - 09	DATE:	02-09-2015													
SCALE:	<b>1:100</b>	PAGE:	09													