





G. DHAASTHAAN, BANAFSA MAGU MALE 20119,  
Republic of Maldives Tel: +960 7917639  
E-Mail: moosaaleem@hotmail.com

**OLD THALASSEMIA BUILDING**  
AS BUILT ARCHITECTURAL DRAWING

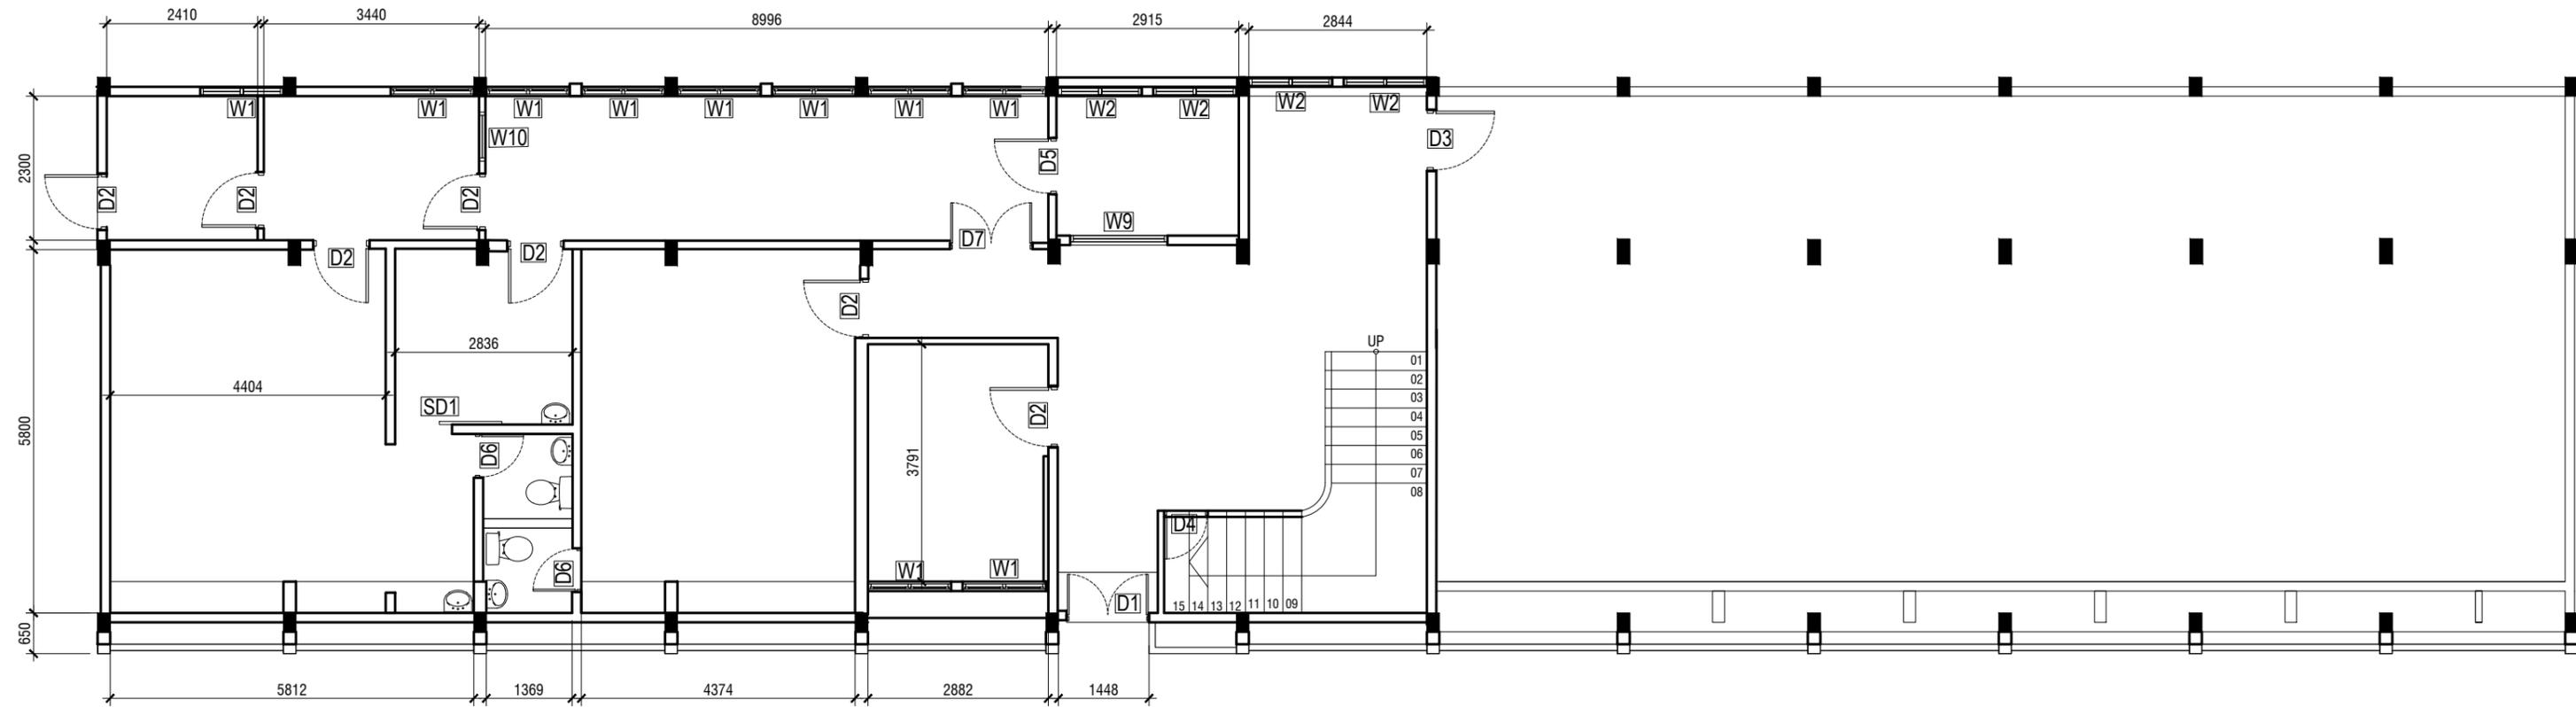

**GROUND FLOOR PLAN**

SCALE 1:100

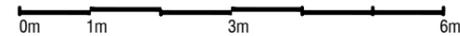

**HATCH**  
DESIGN

G. DHAASTHAAN, BANAFSA MAGU MALE 20119,  
Republic of Maldives Tel: +960 7917639  
E-Mail: moosaaleem@hotmail.com


**GENERAL NOTES**  
ALL DIMENSIONS ARE IN MM. UNLESS OTHERWISE SPECIFIED  
DO NOT SCALE DRAWINGS. USE WRITTEN DIMENSIONS ONLY. IN CASE OF DOUBT, PLEASE ASK CONTRACTOR TO VERIFY ALL DIMENSIONS OF EXISTING WORKS ON SITE BEFORE COMMENCING ANY WORK OR PREPARING SHOP DRAWINGS

REVISION:      DATE:  
DESCRIPTION

CLIENT  
**IGMH**  
PROJECT NAME  
**THALASSEMIA OLD BUILDING MALE'**


STAGE  
**AS BUILT**  
DRAWING TITLE  
**AS GIVEN**      SCALE  
**AS GIVEN**      **AS GIVEN**  
DISCIPLINE  
**ARCHITECTURAL**      DRAWN BY  
**MOOSA ALEEM**  
ARCHITECT  
-  
STR ENGINEER  
-

SHEET SIZE  
**A3**      DRAWING NUMBER  
**A-01**  
SUBMITTED DATE  
**JULY 2025**      REVISION  
**00**

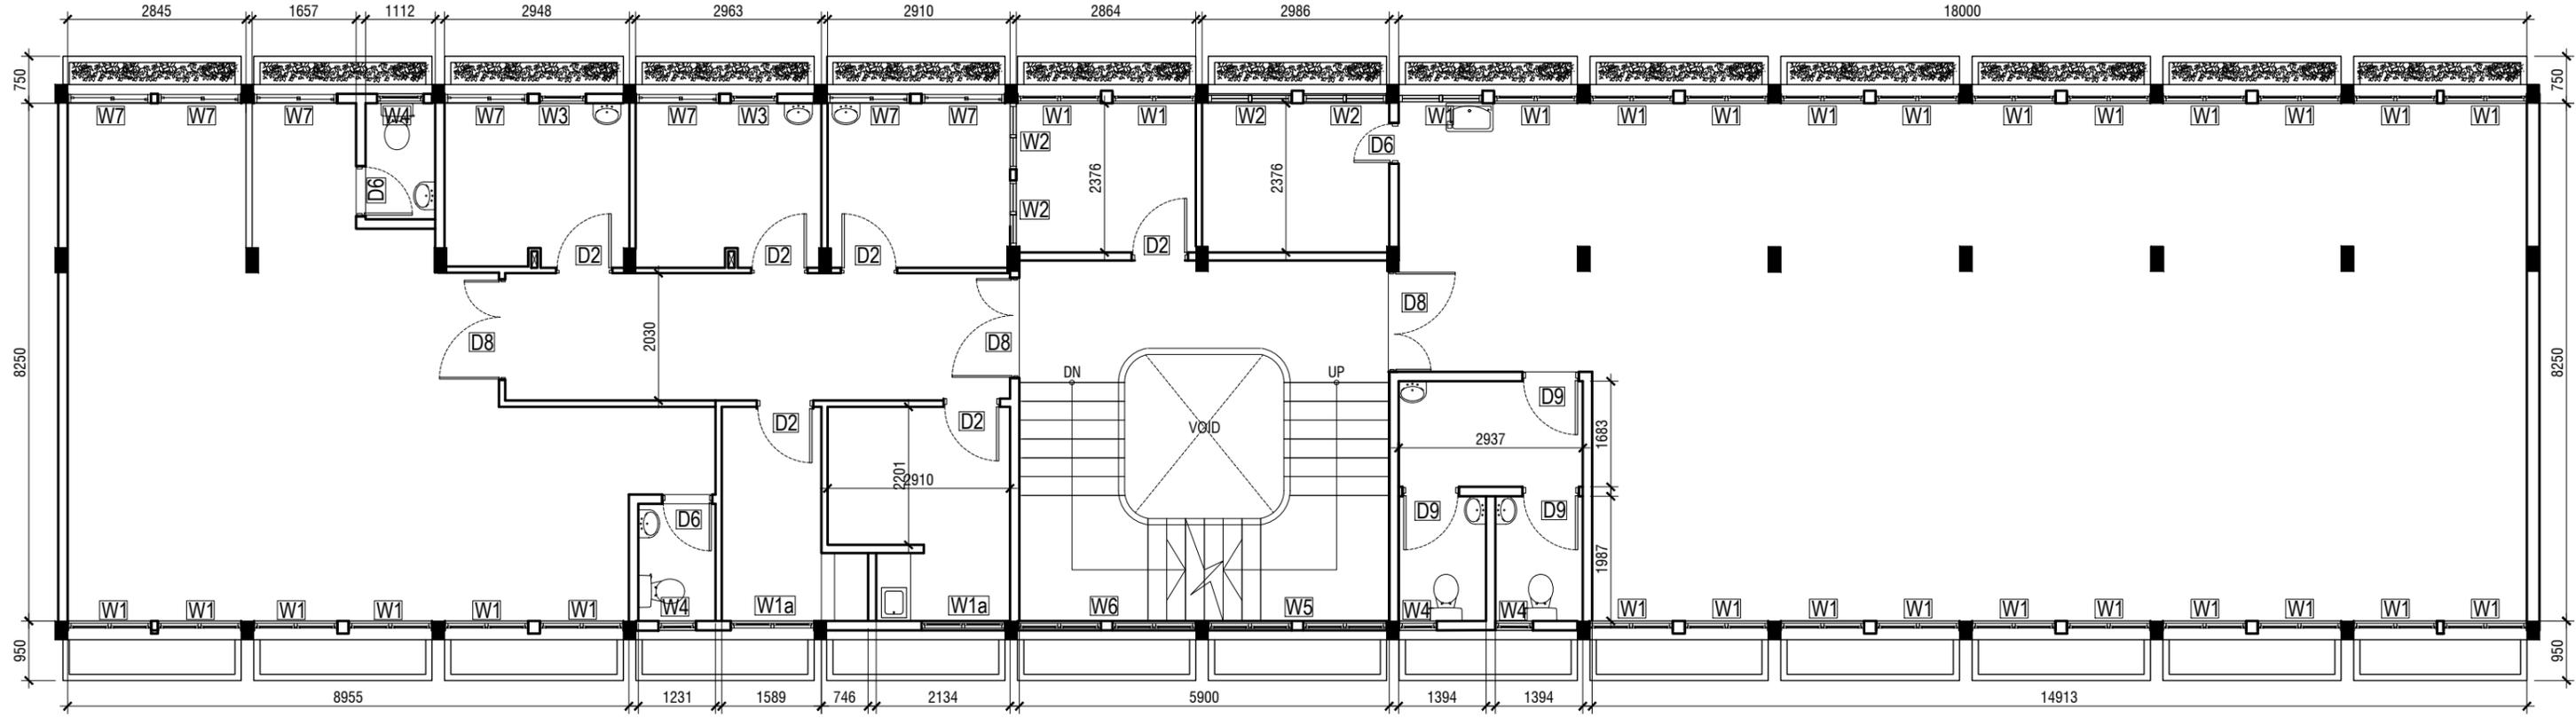

**FIRST FLOOR PLAN**

SCALE 1:100

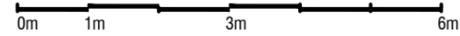

**HATCH**  
DESIGN

G. DHAASTHAAN, BANAFSA MAGU MALE' 20119,  
Republic of Maldives Tel: +960 7917639  
E-Mail: moosaaleem@hotmail.com


**GENERAL NOTES**  
ALL DIMENSIONS ARE IN MM. UNLESS OTHERWISE SPECIFIED  
DO NOT SCALE DRAWINGS. USE WRITTEN DIMENSIONS ONLY. IN CASE OF DOUBT, PLEASE ASK. CONTRACTOR TO VERIFY ALL DIMENSIONS OF EXISTING WORKS ON SITE BEFORE COMMENCING ANY WORK OR PREPARING SHOP DRAWINGS

REVISION:      DATE:  
DESCRIPTION

CLIENT  
**IGMH**  
PROJECT NAME  
**THALASSEMIA OLD BUILDING MALE'**


STAGE  
**AS BUILT**  
DRAWING TITLE      SCALE  
**AS GIVEN**      **AS GIVEN**  
DISCIPLINE      DRAWN BY  
**ARCHITECTURAL**      **MOOSA ALEEM**  
ARCHITECT  
STR ENGINEER

SHEET SIZE      DRAWING NUMBER  
**A3**      **A-02**  
SUBMITTED DATE      REVISION  
**JULY 2025**      **00**

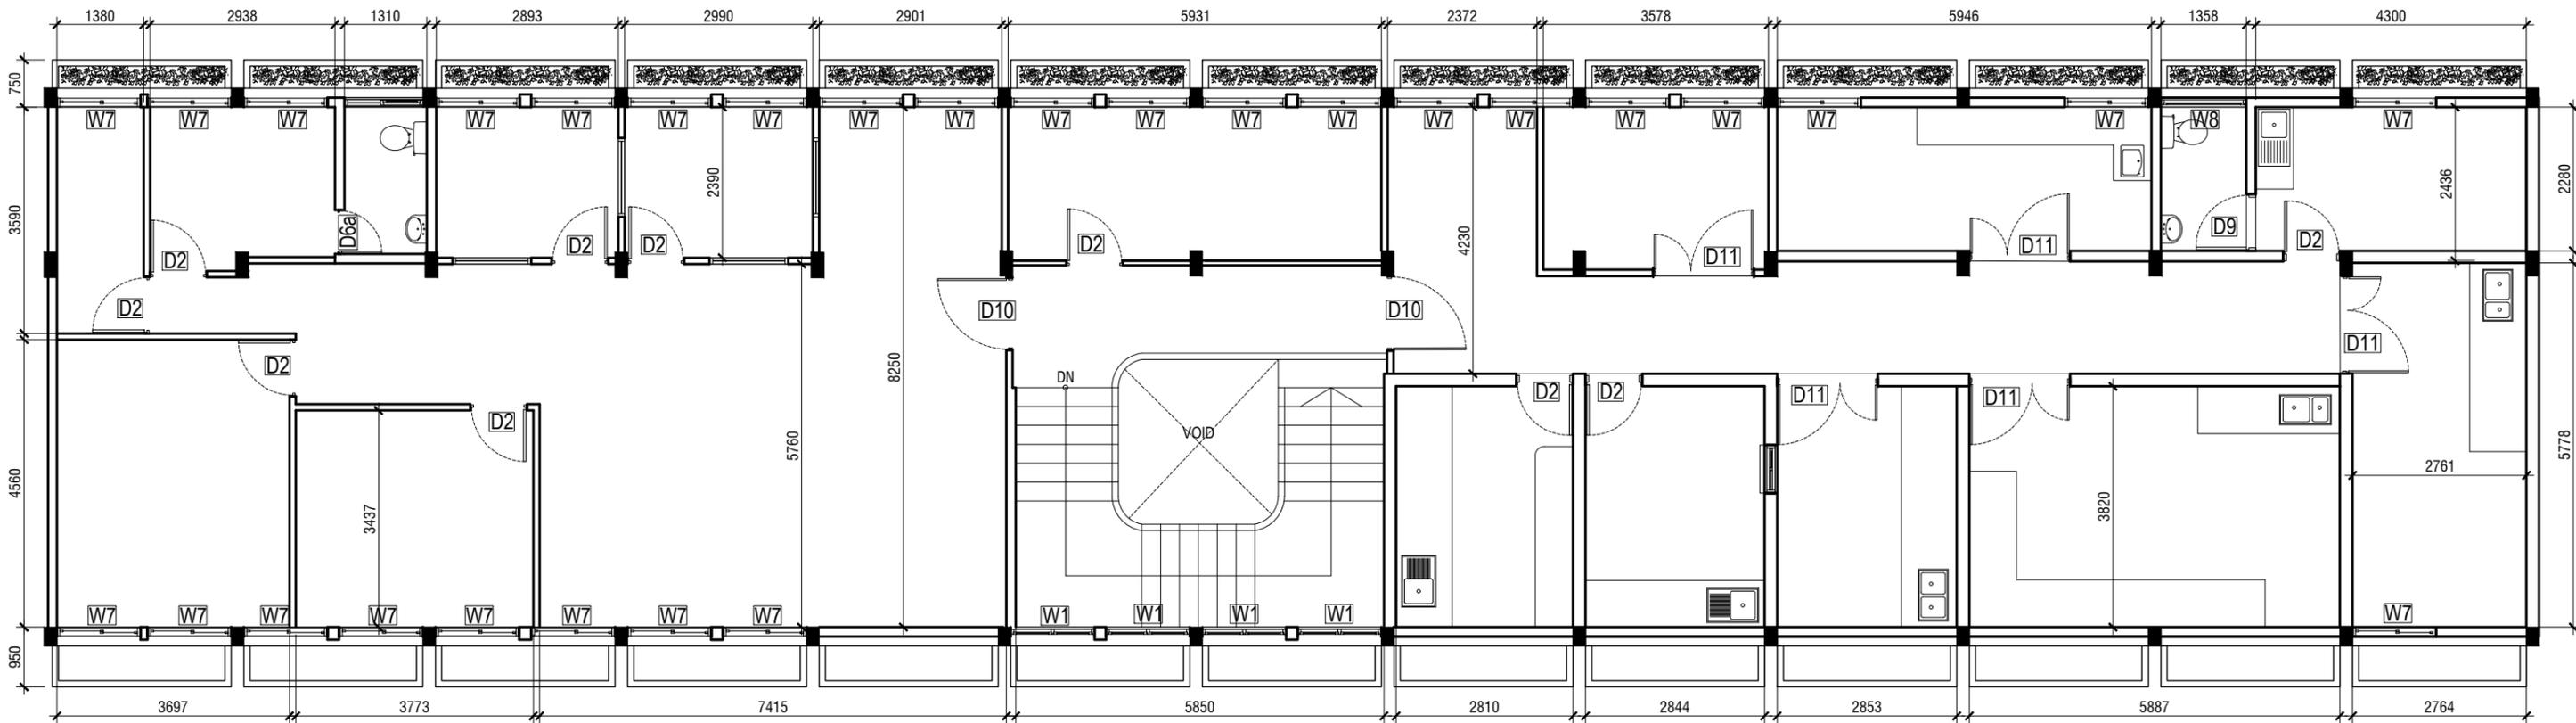

## SECOND FLOOR PLAN

SCALE 1:100

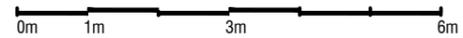

# HATCH

DESIGN

G. DHAASHTHAAN, BANAFSA MAGU MALE 20119,  
 Republic of Maldives Tel: +960 7917639  
 E-Mail: moosaaaleem@hotmail.com

**GENERAL NOTES**  
 ALL DIMENSIONS ARE IN MM. UNLESS OTHERWISE SPECIFIED  
 DO NOT SCALE DRAWINGS. USE WRITTEN DIMENSIONS ONLY IN CASE OF DOUBT. PLEASE ASK CONTRACTOR TO VERIFY ALL DIMENSIONS OF EXISTING WORKS ON SITE BEFORE COMMENCING ANY WORK OR PREPARING SHOP DRAWINGS

REVISION:      DATE:  
 DESCRIPTION

CLIENT  
**IGMH**  
 PROJECT NAME  
**THALASSEMIA OLD BUILDING MALE'**


STAGE  
**AS BUILT**  
 DRAWING TITLE      SCALE  
**AS GIVEN**      **AS GIVEN**  
 DISCIPLINE      DRAWN BY  
**ARCHITECTURAL**      **MOOSA ALEEM**  
 ARCHITECT  
 STR ENGINEER

SHEET SIZE      DRAWING NUMBER  
**A3**      **A-03**  
 SUBMITTED DATE      REVISION  
**JULY 2025**      **00**



**ROOF PLAN**

SCALE 1:100

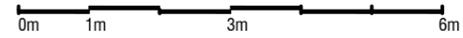

**HATCH**  
DESIGN

G. DHAASTHAAN, BANAFSA MAGU MALE' 2019,  
Republic of Maldives Tel: +960 7917639  
E-Mail: moosaaleem@hotmail.com

**GENERAL NOTES**  
ALL DIMENSIONS ARE IN MM. UNLESS OTHERWISE SPECIFIED  
DO NOT SCALE DRAWINGS, USE WRITTEN DIMENSIONS ONLY IN CASE OF DOUBT, PLEASE ASK. CONTRACTOR TO VERIFY ALL DIMENSIONS OF EXISTING WORKS ON SITE BEFORE COMMENCING ANY WORK OR PREPARING SHOP DRAWINGS

REVISION:	DATE:
DESCRIPTION	

CLIENT  
**IGMH**

PROJECT NAME  
**THALASSEMIA OLD BUILDING MALE'**


STAGE  
**AS BUILT**

DRAWING TITLE	SCALE
<b>AS GIVEN</b>	<b>AS GIVEN</b>

DISCIPLINE	DRAWN BY
<b>ARCHITECTURAL</b>	<b>MOOSA ALEEM</b>
-	ARCHITECT
-	STR ENGINEER
-	



SHEET SIZE	DRAWING NUMBER
<b>A3</b>	<b>A-04</b>

SUBMITTED DATE	REVISION
<b>JULY 2025</b>	<b>00</b>

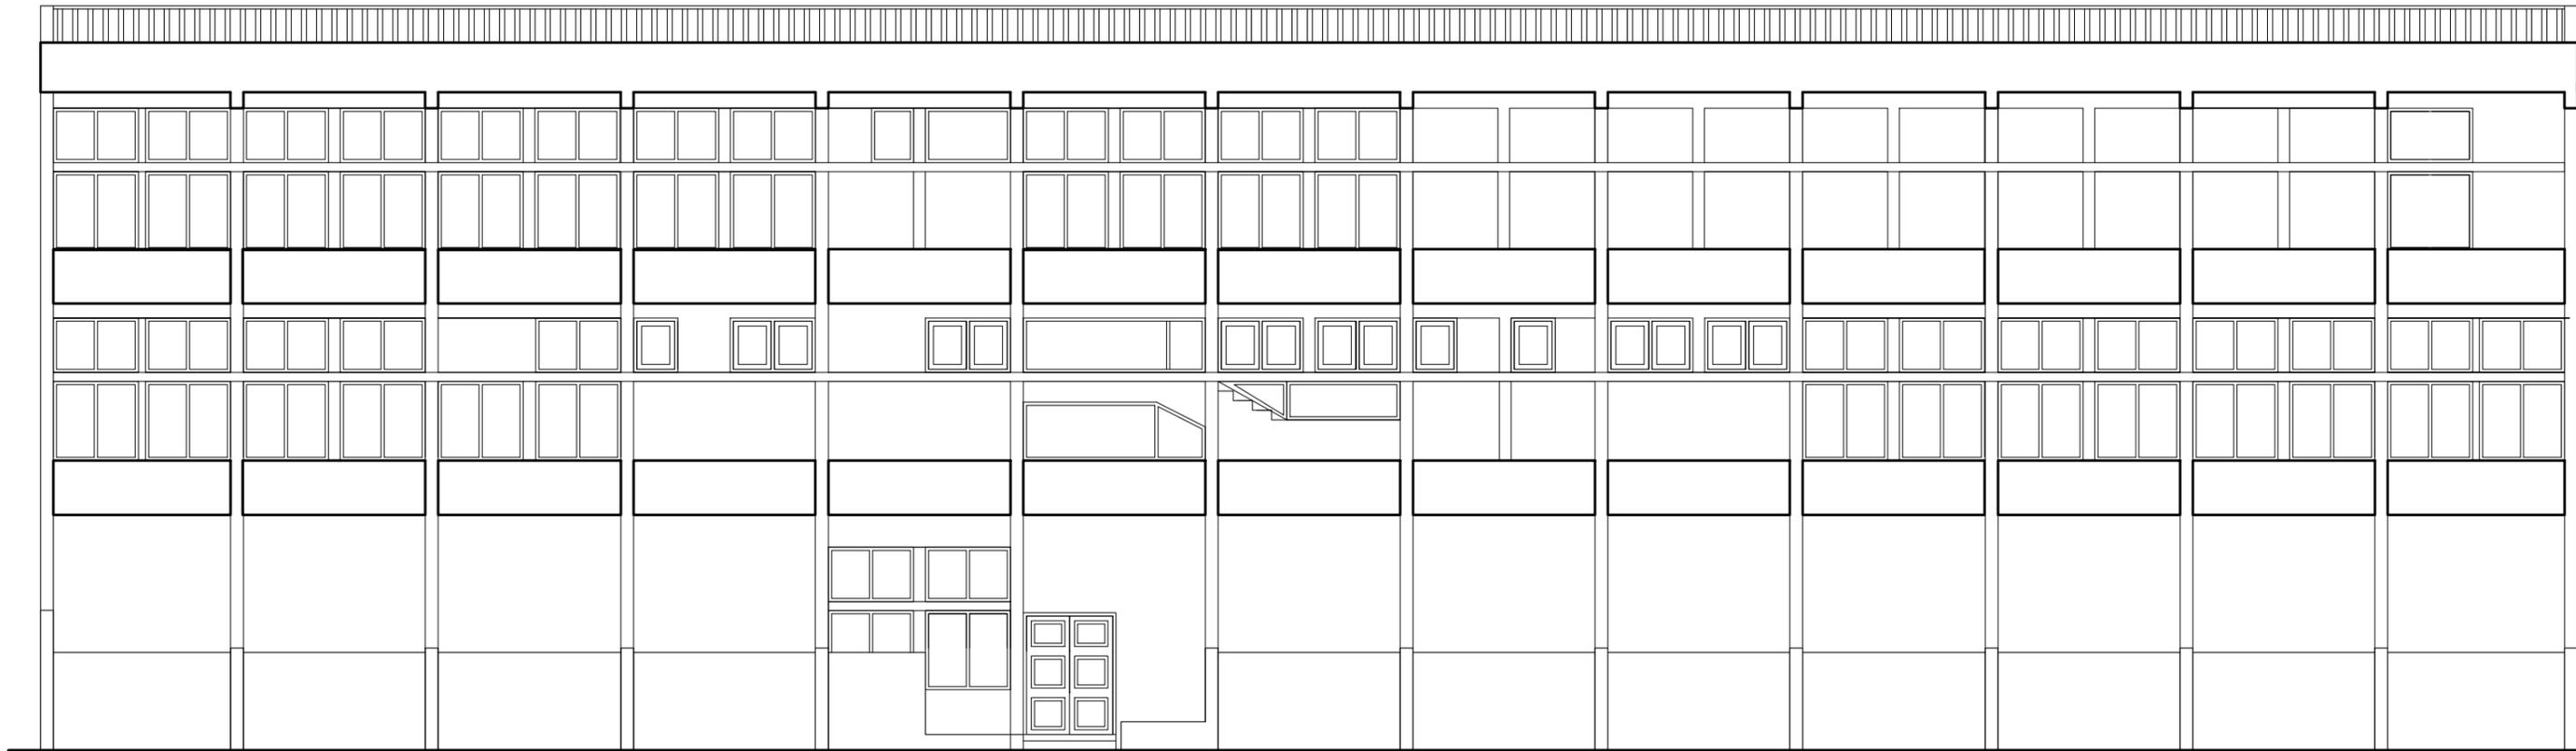


**FRONT ELEVATION**

SCALE 1:100

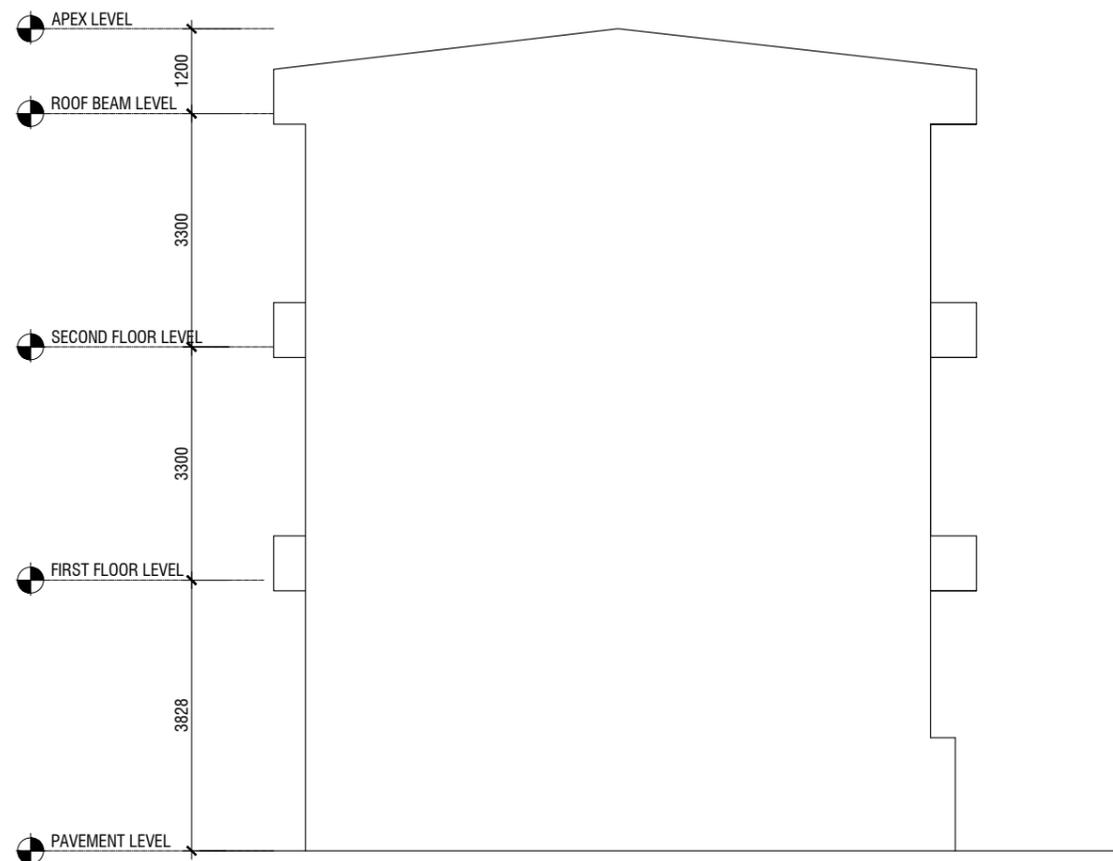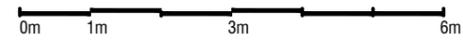

**SIDE ELEVATION**

SCALE 1:100

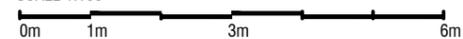

**HATCH**  
DESIGN

G. DHAASTHAAN, BANAFSA MAGU MALE 20119,  
Republic of Maldives Tel: +960 7917639  
E-Mail: moosaaleem@hotmail.com

**GENERAL NOTES**  
ALL DIMENSIONS ARE IN MM. UNLESS OTHERWISE SPECIFIED  
DO NOT SCALE DRAWINGS. USE WRITTEN DIMENSIONS ONLY IN CASE OF DOUBT. PLEASE ASK CONTRACTOR TO VERIFY ALL DIMENSIONS OF EXISTING WORKS ON SITE BEFORE COMMENCING ANY WORK OR PREPARING SHOP DRAWINGS

REVISION:      DATE:  
DESCRIPTION

CLIENT  
**IGMH**  
PROJECT NAME  
**THALASSEMIA OLD BUILDING MALE'**

STAGE  
**AS BUILT**  
DRAWING TITLE      SCALE  
**AS GIVEN      AS GIVEN**  
DISCIPLINE      DRAWN BY  
**ARCHITECTURAL      MOOSA ALEEM**  
ARCHITECT  
-  
STR ENGINEER  
-

SHEET SIZE      DRAWING NUMBER  
**A3      A-05**  
SUBMITTED DATE      REVISION  
**JULY 2025      00**