


# AS BUILT

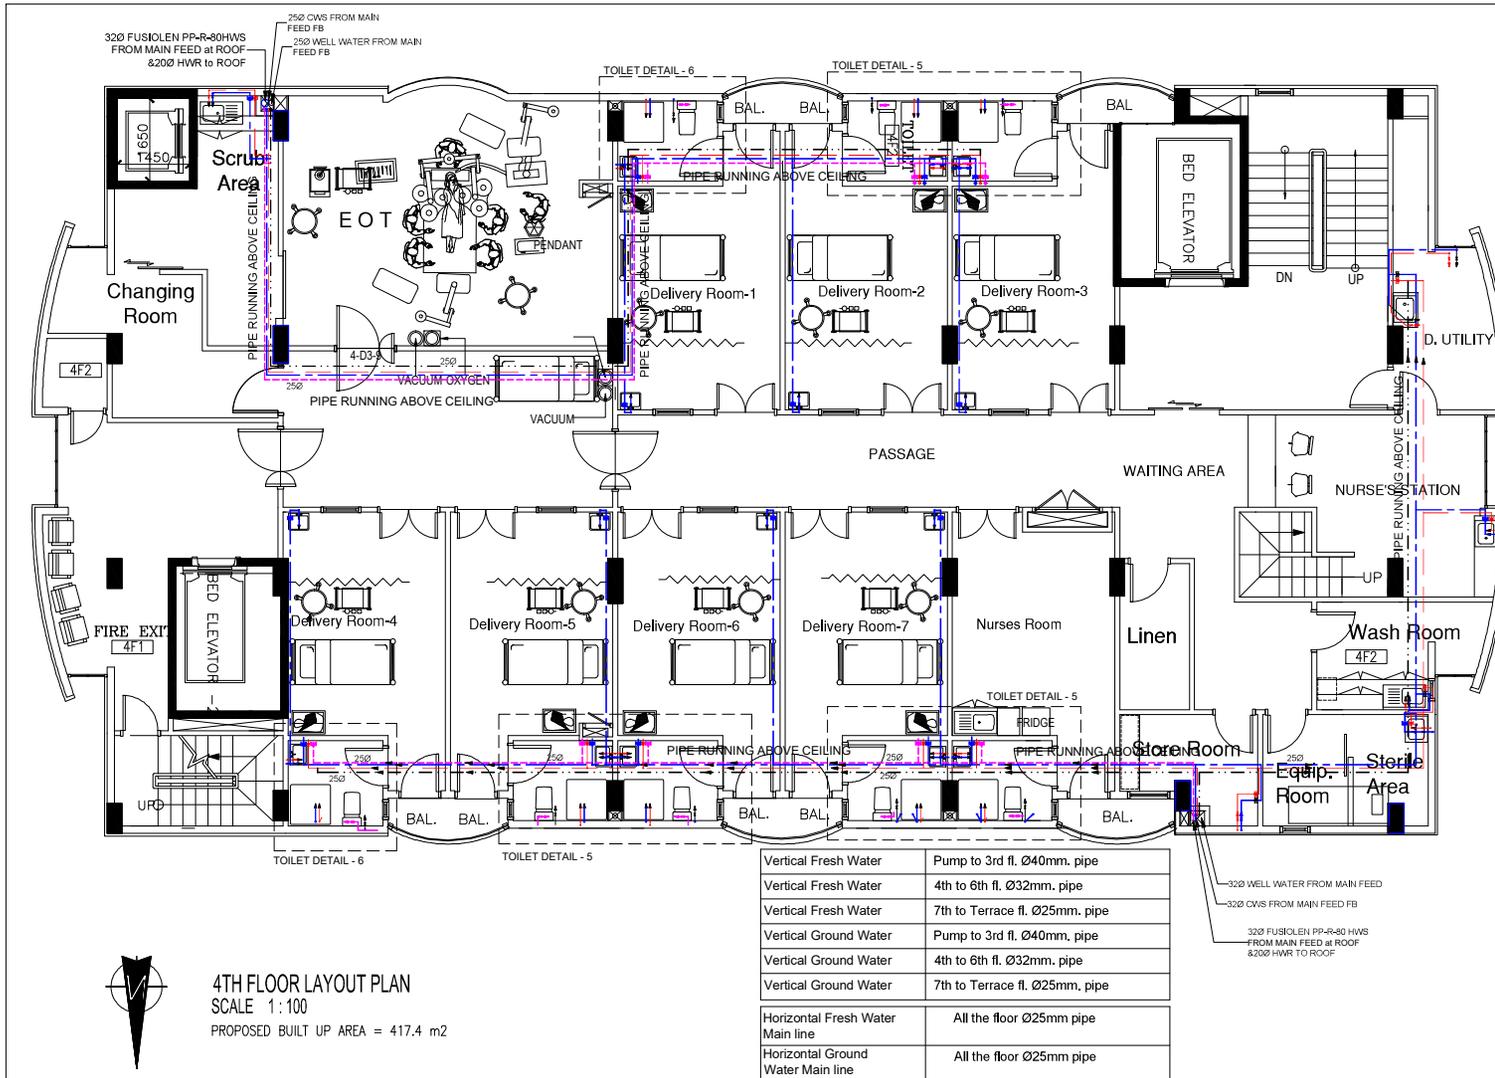

**ABBREVIATION:**

- C.W.S Cold Water for Sink/wb/Tub/wc
- H.W.S Hot Water Supply(Insulated)
- H.W.R Hot Water Return(Insulated)
- V.P Vent Pipe
- R.M Rising Main
- D.O.C Drain Of Cock
- O.F Over Flow
- G.V Gate Valve
- I.V Isolating Valve/Angle Valve
- N.R.V Non Return Valve
- R.T.A Riser to Above
- R.F.B Riser From Below
- D.T.B Drop To Below
- D.F.A Drop From Above
- T.A To Above
- T.B To Below
- F.A From Above
- F.B From Below
- P.S Perennial Spray
- W.B Wash Basin
- S.H Shower

**NOTE:**

- Cold water for sink/wb/shower
- Hot water supply(Insulated)
- Hot water Return(Insulated)
- Well water for Water closet
- STOP VALVE COLD WATER
- STOP VALVE WELL WATER
- STOP VALVE HOT WATER

Vertical Fresh Water	Pump to 3rd fl. Ø40mm. pipe
Vertical Fresh Water	4th to 6th fl. Ø32mm. pipe
Vertical Fresh Water	7th to Terrace fl. Ø25mm. pipe
Vertical Ground Water	Pump to 3rd fl. Ø40mm. pipe
Vertical Ground Water	4th to 6th fl. Ø32mm. pipe
Vertical Ground Water	7th to Terrace fl. Ø25mm. pipe
Horizontal Fresh Water Main line	All the floor Ø25mm pipe
Horizontal Ground Water Main line	All the floor Ø25mm pipe



**4TH FLOOR LAYOUT PLAN**  
SCALE 1 : 100

PROPOSED BUILT UP AREA = 417.4 m<sup>2</sup>

MAIN CONTRACTOR:

**AMIN construction**  
private limited

52, Bodubhakarutshanu Magu, Mafanaru,  
Male' 20101, Maldives, Tel: +960 3328426  
Fax: +960 3328424  
Email: amin@aminprivetel.net.mv  
Web: http://www.amin.com.mv

CONSULTANT:

CLIENT:

MINISTRY OF HEALTH

PROJECT

**PROPOSED ADDITIONAL WARDS FOR  
INDIRA GANDHI MEMORIAL HOSPITAL**

TITLE  
**4TH FLOOR WATER SUPPLY LAYOUT  
PLAN**

DRAWN BY:	ZAHID	CHECKED BY:	
DRG. NO. :	PL - 05	DATE:	02-09-2015
SCALE:	<b>1:100</b>	PAGE:	05