


# AS BUILT

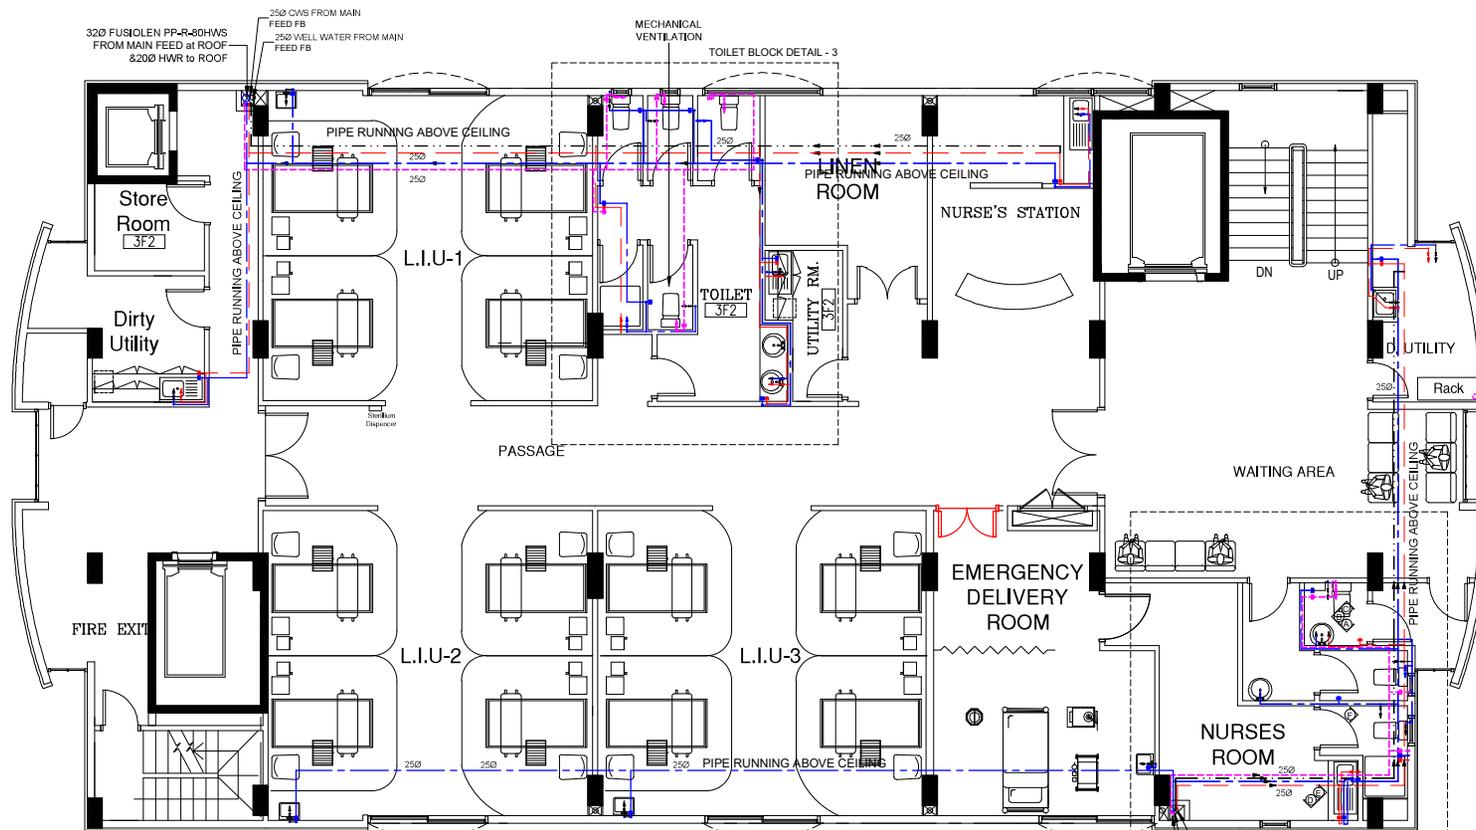

**ABBREVIATION:**

- C.W.S Cold Water for Sink/wb//Tub/wc
- H.W.S Hot Water Supply(Insulated)
- H.W.R Hot Water Return(Insulated)
- V.P Vent Pipe
- R.M Rising Main
- D.O.C Drain Of Cock
- O.F Over Flow
- G.V Gate Valve
- LV Isolating Valve/Angle Valve
- N.R.V Non Return Valve
- R.T.A Riser to Above
- R.F.B Riser From Below
- D.T.B Drop To Below
- D.F.A Drop From Above
- T.A To Above
- T.B To Below
- F.A From Above
- F.B From Below
- P.S Perennial Spray
- W.B Wash Basin
- S.H Shower

**NOTE:**

- Cold water for sink/wb/shower
- Hot water supply(Insulated)
- Hot water Return(Insulated)
- Well water for Water closet
- STOP VALVE COLD WATER
- STOP VALVE WELL WATER
- STOP VALVE HOT WATER

Vertical Fresh Water	Pump to 3rd fl. Ø40mm. pipe
Vertical Fresh Water	4th to 6th fl. Ø32mm. pipe
Vertical Fresh Water	7th to Terrace fl. Ø25mm. pipe
Vertical Ground Water	Pump to 3rd fl. Ø40mm. pipe
Vertical Ground Water	4th to 6th fl. Ø32mm. pipe
Vertical Ground Water	7th to Terrace fl. Ø25mm. pipe
Horizontal Fresh Water Main line	All the floor Ø25mm pipe
Horizontal Ground Water Main line	All the floor Ø25mm pipe

LIU / Early Labour



**3RD FLOOR LAYOUT PLAN**  
 SCALE 1 : 100  
 PROPOSED BUILT UP AREA = 417.4 m2

MAIN CONTRACTOR: AMIN construction private limited S2, Bodufakunufanu Magu, Maafarmu, Male' 20-01, Maldives, Tel +960 3324369 Fax: +960 3328424 Email: amin@divineinet.net.mv Web: http://www.amin.com.mv	CONSULTANT:	CLIENT: MINISTRY OF HEALTH	PROJECT: PROPOSED ADDITIONAL WARDS FOR INDIRA GANDHI MEMORIAL HOSPITAL	TITLE: 3RD FLOOR WATER SUPPLY LAYOUT PLAN	
DRAWN BY: ZAHID	CHECKED BY:	DRG. NO.: PL-04	DATE: 02-09-2015	SCALE: 1:100	PAGE: 04